



12/10/2024

ADDENDUM NO. 4

PROJECT: Saline Area Schools – 2022 Bond Program – MS Rec Complex
DESCRIPTION: Addendum No.4
BID PACKAGE RELEASE NUMBER: BP #3

BID PROPOSAL DUE DATE/TIME: 2:00 PM, Friday, December 13th, 2024

The following clarifications and/or Changes made to the Contract Documents are hereby made part of the Contract Documents.

The general character of the Work clarified or revised by this Addendum shall be the same as required by the complete set of Contract Documents. All incidentals required in connection with the Work of this Addendum shall be included in the Scope of Work even though not specifically specified.

All bidders shall be held responsible to review the Addendum and to include in its Bid Proposal all Work reasonably inferred to be included in its Scope of Work.

Acknowledge receipt of this Addendum in the space provided on the Bid Proposal Form.

- A. Division 00 – Bidding and Contract Requirement Modifications:**
 - 1. SECTION 004126 – Bid Form**
 - i. Revised Unit Price (Updated on BuildingConnected)**
 - 1. Excavation of contaminated soils and disposal off-site
 - a) Revised to per Ton
 - 2. Section 002416 – Scope of Work – Bid Category Specific Notes**
 - i. Bid Category 32F – Landscaping (Reissued)**

Architect/Engineering Documentation

3. ADDENDUM No. 4, December 10th, 2024 as issued by Kingscott
(Attached)

END OF SECTION

SECTION 002416
SCOPE OF WORK
BID CATEGORY SPECIFIC NOTES

BID CATEGORY 32F-Landscaping

GENERAL – The following shall not be interpreted as a complete itemization of the work to be performed under this Bid Category. This Bid Category Trade Contractor shall be responsible to perform all work reasonably interpreted to be included in its scope of work in accordance with the drawings and specifications in addition to these Bid Category notes of clarification.

BASE SPECIFICATION - (Include **all** Work specified or reasonably inferred)

002413 – SCOPE OF WORK GENERAL NOTES

329200 – TURFS AND GRASSES

329220 – TOPSOIL

329300 – LANDSCAPE PLANTING

329400 – LANDSCAPE MAINTENANCE AND WARRANTY STANDARDS

REFERENCE SPECIFICATION - (Include portions of the Work specified as noted below)

015000 – Temporary Facilities and Controls

311012 – FINE GRADING

313219 – GEOTEXTILE FABRIC

Include (Furnish and Install u.n.o):

1. Verify location of existing utilities prior to performing the work. Hand dig as required to avoid contact with underground utilities.
2. Furnish sleeves to other Trades to accommodate the work of this bid category. Provide layout and assistance with placement.
3. Verify existing grades at planting and lawn areas prior to performing the work. Report discrepancies to Clark Construction Company.
4. Topsoil raking and removal of rocks, stones and debris.
5. Clean-up on a daily basis.
6. Legally dispose of debris off site.
7. Broom cleaning of hard surfaces.
8. Initial staking/support of plantings.
9. Final connection of irrigation system to water supply.
10. Weed control and fertilizer per specifications.
11. Temporary watering as required until irrigation system is fully functioning.
12. Furnish, place and grade topsoil in accordance with the documents.
13. Rock hounding of subgrade prior to placement of topsoil and/or sod.
14. Furnish topsoil as required in addition to site stockpile to meet contract requirements.

SECTION 002416
SCOPE OF WORK
BID CATEGORY SPECIFIC NOTES

15. Screening of topsoil.
16. Verify that quantity of topsoil to be stripped from site and stockpiled is adequate.
17. Load, transport and grade topsoil from site stockpile.
18. First lawn mowing.
19. Grade and hydro-seed areas disturbed outside of the property lines.
20. Maintain streets and public areas free of dirt, mud and debris. Daily or more frequent road sweeping as required when debris is tracked onto roads.
21. Include all restoration shown per the "Restoration Limits". Coordinate restoration with other bid categories. Restoration limits shown typically on Grading Plans (C6 Drawings).
22. Furnish and install Keystone Broadstone wall or approved equal shown on C4.2 including signed and sealed engineered shop drawings.
 - a. Excavation and backfill is the responsibility of this bid category.
23. Include an allowance of \$10,000 for miscellaneous restoration.
24. Furnish and install 1' maintenance strip under all fences in lawn areas per detail 4 on LD4.01.

Exclude:

1. Topsoil (Athletics) and sod inside the baseball and softball fields. See Bid Category 31B to coordinate the limits of this work.
2. Irrigation for Athletics
3. Fencing

**SEE ATTACHMENT A for sitework scope breakdown.

Date: December 10, 2024
Name of Job: Saline Middle School Rec Complex
Owner of Job: Saline Area Schools
Location: 7190 N. Maple Rd. Saline, MI 48176
A/E #: 2900.09B DF

ADDENDUM No. 4

SPECIAL NOTE:

The Notice to Bidders, Instructions to Bidders, General Conditions of the Contract for Construction, Supplementary Conditions of the Contract for Construction, and all modifications and previously issued Contract Documentation are a part of this Addendum.

SCOPE OF WORK:

The following items are changes, additions, deletions, clarifications and/or errors and omissions in plans & specifications and shall be considered by each Bidder in making up and submitting their proposal. All items shall be considered a part of the Contract Documents.

NOTICE TO ALL BIDDERS:

All Bidders shall take note of all items covered by this Addendum. Each Bidder shall review the total scope of his responsibilities with respect to his contract work and his interface with the work of others, as well as his required interface with their work.

ATTACHMENTS:

Drawings: C6.2, C6.3, C6.4.

SPECIFICATIONS: 312000 Earth Moving.

Item No. 1. Refer to Specification 31200 Earth Moving (re-issued):
A. Modified 3.12 fill requirements.

DRAWINGS:

Item No. 2. Refer to sheets C6.2, C6.3, and C6.4 (re-issued):
A. Added infiltration limits to sheet C6.2, C6.3, and C6.4.

END OF ADDENDUM

SECTION 312000
EARTH MOVING

PART 1 – GENERAL

1.1 RELATED DOCUMENTS

- A. Drawings and general provisions of the Contract, including General and Supplementary Conditions and Division 01 Specification Sections, apply to this Section.
- B. All earthwork operations shall conform to the current Michigan Department of Transportation standards and specifications.
- C. CAD files will be made available for use in construction staking. Contact the engineer regarding applicable fee and requirements for signing of the CAD File Transfer Agreement.

1.2 SUMMARY

- A. This Section includes the following:
 - 1. Preparing subgrades for slabs-on-grade, walks, pavements, lawns, and plantings.
 - 2. Subbase course for concrete walks and pavements.
 - 3. Base course for asphalt paving.
 - 4. Excavation and backfill for utility trenches.
- B. Related Sections include the following:
 - 1. Division 31 1000 Section "Site Clearing" for site stripping, grubbing, removing topsoil, and protecting trees to remain.
 - 3. Division 33 4100 Section "Storm Sewers, Underdrains, and Drainage Structures" for storm drainage system.

1.3 DEFINITIONS

- A. Backfill: Soil materials used to fill an excavation.
- B. Base Course: Layer placed between the subbase course and asphalt paving.
- C. Bedding Course: Layer placed over the excavated subgrade in a trench before laying pipe.
- D. Borrow: Satisfactory soil imported from off-site for use as fill or backfill.
- E. Drainage Course: Layer supporting slab-on-grade used to minimize capillary flow of pore water.
- F. Engineered Fill: Fill placed and compacted to densities specified herein, in a controlled manner using lift thickness limited herein, monitored and tested by the Testing Agency or independent Geotechnical Inspector.
- G. Excavation: Removal of material encountered above subgrade elevations.

- H. Fill: Soil materials used to raise existing grades.
- I. Rock: Rock material in beds, ledges, unstratified masses, and conglomerate deposits and boulders of rock material 3/4 cu. yd. (0.57 cu. m) or more in volume.
- J. Structures: Buildings, footings, foundations, retaining walls, slabs, tanks, curbs, mechanical and electrical appurtenances, or other man-made stationary features constructed above or below the ground surface.
- K. Subbase Course: Layer placed between the subgrade and base course for asphalt paving, or layer placed between the subgrade and a concrete pavement or walk.
- L. Subgrade: Surface or elevation remaining after completing excavation, or top surface of a fill or backfill immediately below subbase, drainage fill, or topsoil materials.
- M. Undercutting: Necessary excavation of poor quality soils which occur below the existing Topsoil and any uncontrolled fill soils as described in the Geotechnical Investigation.
- N. Utilities include on-site underground pipes, conduits, ducts, and cables, as well as underground services within buildings.

1.4 SUBMITTALS

- A. Product Data: For the following:
 - 1. Drainage fabric if required for the project .
 - 2. Separation fabric if required for the project.
- B. Test Reports: Testing Agency shall submit the following reports directly to the architect and shall copy the contractor:
 - 1. Analysis of soil materials, whether procured on or off site, and including fill, backfill, and borrow materials.
 - 2. In-place density test reports.
 - 3. Moisture-density relationship test reports.
 - 4. Compressive strength or bearing test reports.
- C. Material Test Reports: Interpreting test results for compliance of the following with requirements indicated:
 - 1. Classification according to ASTM D 2487 of each on-site or borrow soil material proposed for fill and backfill.

1.5 QUALITY ASSURANCE

- A. Testing Agency Services
 - 1. The Owner will secure and pay for the services of a qualified, independent geotechnical engineer to classify existing soil materials, to recommend and to classify proposed borrow materials when necessary, to verify compliance of materials with specified requirements, and to perform required field and laboratory testing. Geotechnical engineer shall be acceptable to the architect and the owner and shall be licensed to practice in the state in which the project is located.
- B. Pre-excavation Conference: Conduct conference at Project site to comply with requirements in project documents.

1.6 PROJECT CONDITIONS

- A. Existing Utilities: Do not interrupt utilities serving facilities occupied by Owner or others unless permitted in writing by Architect or Owner and then only after arranging to provide temporary utility services according to requirements indicated:
 - 1. Notify Architect and Owner not less than three (3) calendar days in advance of proposed utility interruptions.
 - 2. Do not proceed with utility interruptions without Architect's or Owner's written permission.
 - 3. Contact utility-locator service for area where Project is located before excavating.
- B. Demolish and completely remove from site existing underground utilities indicated to be removed. Coordinate with utility companies to shut off services if lines are active.

PART 2 – PRODUCTS

2.1 SOIL MATERIALS

- A. General: Provide borrow soil materials without additional cost to Owner when sufficient satisfactory soil materials are not available from excavations. Contractor is responsible for doing an independent earthwork calculation and including any import of appropriate fill material required to bring the site to the proposed grades.
- B. Satisfactory Soil Material (ASTM D 2487): Free of stones larger than 2 inches in any dimension, trash, debris, organic material, other objectionable material and classified as follows:
 - 1. GP (poorly graded gravel).
 - 2. GM (silty gravel).
 - 3. GC (clayey gravel).
 - 4. SW (well-graded sand).
 - 5. SP (poorly graded sand).
 - 6. SM (silty sand).
- C. Unsatisfactory Soil Material (ASTM D 2487):
 - 1. SC (clayey sand).
 - 2. CL (lean clay).
 - 3. ML (silt).
 - 4. OL (organic clay).
 - 5. OL (organic silt).
 - 6. CH (fat clay).
 - 7. MH (elastic silt).
 - 8. OH (organic clay).
 - 9. OH (organic silt).
 - 10. PR (peat).
- D. Backfill and Fill: Satisfactory soil materials.

- E. Subbase: Naturally or artificially graded mixture of natural or crushed gravel, crushed stone, and natural or crushed sand; ASTM D 2940; Generally either an MDOT Class II sand or 21AA gravel will meet this requirement. Refer to the plans for specific requirements.
 - F. Base: Naturally or artificially graded mixture of natural or crushed gravel, crushed stone, and natural or crushed sand; ASTM D 2940; Generally either an MDOT Class II sand or 21AA gravel will meet this requirement. Refer to the plans for specific requirements.
 - G. Engineered Fill: Naturally or artificially graded mixture of natural or crushed gravel, crushed stone, and natural or crushed sand; ASTM D 2940; Generally either an MDOT Class II sand or 21AA gravel will meet this requirement.
 - 1. Clean granular fill meeting MDOT Class II grading requirements.
 - 2. On-site granular deposits within the excavation can be used as engineered fill if approved by the geotechnical engineer and if selective excavation procedures are employed to manage existing clay deposits.
 - 3. Import fill as required to make-up volumes necessary to raise the building site.
 - 4. Refer to the plans for specific requirements.
 - H. Bedding: Naturally or artificially graded mixture of natural or crushed gravel, crushed stone, and natural or crushed sand; Generally either an MDOT 3G, 5G, 6A, or 34R will meet this requirement. Bedding requirements of the agencies having jurisdiction over the utility installation take precedence over these specifications.
 - I. Drainage Fill: Washed, narrowly graded mixture of crushed stone, or crushed or uncrushed gravel; ASTM D 448; Generally either an MDOT 6A or 34R will meet this requirement. Refer to the plans for specific requirements.
 - J. Impervious Fill: Clayey gravel and sand mixture capable of compacting to a dense state.
- 2.2 ACCESSORIES
- A. Drainage Fabric: Nonwoven geotextile, specifically manufactured as a drainage geotextile; made from polyolefins, polyesters, or polyamides; with minimum properties determined according to ASTM D 4759 and referenced standard test methods.
 - B. Separation Fabric: Woven geotextile, specifically manufactured for use as a separation geotextile; made from polyolefins, polyesters, or polyamides; with minimum properties determined according to ASTM D 4759 and referenced standard test methods.

PART 3 – EXECUTION

3.1 PREPARATION

- A. Protect structures, utilities, sidewalks, pavements, and other facilities from damage caused by settlement, lateral movement, undermining, washout, and other hazards created by earthwork operations.
- B. Protect subgrades and foundation soils against freezing temperatures or frost. Provide protective insulating materials as necessary.

- C. Provide erosion-control measures approved by agency having jurisdiction to prevent erosion or displacement of soils and discharge of soil-bearing water runoff or airborne dust to adjacent properties and walkways.

3.2 EXPLOSIVES

- A. Explosives: Explosives are prohibited for use on the Project site.

3.3 EXCAVATION, GENERAL

- A. General: Excavation includes the removal of any materials necessary to achieve the required subgrade elevations and includes reuse or disposal of such materials.
- B. Unnecessary Excavation: The expense of excavation of materials outside of limits indicated or ordered in writing by the architect and the correction thereof to the satisfaction of the architect shall be borne by the contractor.
 - 1. Unnecessary excavation under footings: Either deepen footings to bear on actual subgrade elevation without changing top elevations or place concrete fill up to required elevation, as required by the architect.
 - 2. Unnecessary excavation other than under footings: Either place compacted fill or otherwise correct conditions, as required by the architect.
- C. Approval of Subgrade: Notify the Testing Agency when required elevations have been reached.
 - 1. When required by the architect due to the unforeseen presence of unsatisfactory materials or other factors, perform additional excavation and replace with approved compacted fill material in accordance with the architect's or geotechnical engineer's instructions.
 - 2. Payment for unforeseen additional work will be made in accordance with established unit prices or, if none, in accordance with provisions for changes in the work. No payment will be made for correction of subgrades improperly protected against damage from freeze-thaw or accumulation of water, or for correction of otherwise defective subgrades.
- D. Excavation Stabilization: Slope faces of excavations to maintain stability in compliance with requirements of governing authorities. Do not use shoring and bracing where faces can be sloped.

3.4 EXCAVATION FOR STRUCTURES

- A. Do not proceed with excavations for building structures until Subgrade Preparation operations are complete and tested.
- B. Excavate to indicated elevations and dimensions within a tolerance of plus or minus 1 inch (25 mm). Extend excavations a sufficient distance from structures for placing and removing concrete formwork, for installing services and other construction, and for inspections.
 - 1. Excavations for Footings and Foundations: Do not disturb bottom of excavation. Excavate by hand to final grade just before placing concrete reinforcement. Trim bottoms to required lines and grades to leave solid base to receive other work.
 - 2. Pile Foundations: Stop excavations from 6 to 12 inches (150 to 300 mm) above bottom of pile cap before piles are placed. After piles have been driven, remove loose and displaced material. Excavate to final grade, leaving solid base to receive concrete pile caps.

3. Excavation for Underground Tanks, Basins, and Mechanical or Electrical Utility Structures: Excavate to elevations and dimensions indicated within a tolerance of plus or minus 1 inch (25 mm). Do not disturb bottom of excavations intended for bearing surface.
 - C. Coordinate excavations with Dewatering operations as required to allow construction of foundations to dry.
- 3.5 EXCAVATION FOR WALKS AND PAVEMENTS
- A. Excavate surfaces under walks and pavements to indicated cross sections, elevations, and grades.
- 3.6 EXCAVATION FOR UTILITY TRENCHES
- A. Excavate trenches to indicated gradients, lines, depths, and elevations.
 - B. Excavate trenches to uniform widths to provide a working clearance on each side of pipe or conduit. Excavate trench walls vertically from trench bottom to 12 inches (300 mm) higher than top of pipe or conduit, unless otherwise indicated.
 - C. Trench Bottoms: Excavate and shape trench bottoms in accordance with the plans and standard details. Excavate trenches a minimum 4 inches (100 mm) deeper than bottom of pipe elevation to allow for bedding course (excavate deeper as required by the regulating agency). Hand excavate for bell of pipe. Remove projecting stones and sharp objects along trench subgrade.
 1. Excavate trenches a minimum 4 inches (100 mm) deeper than bottom of pipe elevation to allow for bedding course (excavate deeper as required by the regulating agency). Hand excavate for bell of pipe. Remove projecting stones and sharp objects along trench subgrade. Provide bedding course per the plan notes and/or details.
- 3.7 SUBGRADE PREPARATION AND INSPECTIONS
- A. Perform mass earthwork operations to remove all existing topsoil and other organic materials in their entirety within the footprint of the proposed building and pavement areas. Buried objects should be removed in their entirety.
 - B. Notify Testing Agency when excavations have reached required subgrade elevations.
 - C. Proof-roll subgrade in the presence of the Testing Agency to identify soft pockets and areas of excess yielding. Do not proof-roll wet or saturated subgrades.
 1. Completely proof-roll subgrade in one direction repeating proof-rolling in direction perpendicular to the first direction. Limit vehicle speed to 3 mph.
 2. Proof-roll subgrade with heavy pneumatic-tired equipment or loaded 10-wheel, tandem-axle truck weighing not less than 15 tons.
 3. Excavate soft spots, unsatisfactory soils, and areas of excessive pumping or rutting, as determined by the Testing Agency, and replace with engineered fill as directed.
 - D. If Testing Agency determines that unsatisfactory soil is present, continue excavations and replace with compacted backfill or fill materials as directed.
 1. Additional excavation and replacement material will be paid for according to Contract provisions for changes in the Work.
 - E. Reconstruct subgrades damaged by freezing temperatures, frost, rain, accumulated water, or construction activities.

3.8 UNAUTHORIZED EXCAVATION

- A. Fill unauthorized excavation under foundations or wall footings by extending bottom elevation of concrete foundation or footing to excavation bottom, without altering top elevation. Lean concrete fill may be used at no additional cost to the Owner.

3.9 STORAGE OF SOIL MATERIALS

- A. Stockpile borrow materials and satisfactory excavated soil materials. Stockpile soil materials without intermixing. Place, grade, and shape stockpiles to drain surface water. Cover to prevent windblown dust.
 - 1. Stockpile soil materials away from edge of excavations. Do not store within drip line of remaining trees.

3.10 BACKFILL

- A. Place and compact backfill in excavations promptly, but not before completing the following:
 - 1. Construction below finish grade including, where applicable, dampproofing, waterproofing, and perimeter insulation.
 - 2. Surveying locations of underground utilities for record documents.
 - 3. Inspecting and testing underground utilities.
 - 4. Removing concrete formwork.
 - 5. Removing trash and debris.
 - 6. Removing temporary shoring and bracing, and sheeting.
 - 7. Installing permanent or temporary horizontal bracing on horizontally supported walls.

3.11 UTILITY TRENCH BACKFILL

- A. Place and compact bedding course on trench bottoms and where indicated. Shape bedding course to provide continuous support for bells, joints, and barrels of pipes and for joints, fittings, and bodies of conduits.
- B. Place and compact initial backfill of subbase material, free of particles larger than 1 inch (25 mm), to a height of 12 inches (300 mm) over the utility pipe or conduit. All pipe backfill to be done according to the details shown on the plans or the requirements of the regulating agency.
- C. Fill voids with approved backfill materials while shoring and bracing, and as sheeting is removed.

3.12 FILL

- A. Preparation: Remove vegetation, topsoil, debris, unsatisfactory soil materials, obstructions, and deleterious materials from ground surface before placing fills.
- B. Plow, scarify, bench, or break up sloped surfaces steeper than 1 vertical to 4 horizontal so fill material will bond with existing material.
- C. Place and compact fill material in layers to required elevations as follows:
 - 1. Under grass and planted areas, use satisfactory soil material **and/or unsatisfactory soil material SC, CL, and ML as long as the compaction requirements are met.**
 - 2. **Under walks and pavements within recreation complex, ie west of heavy-duty main north/south drive, use satisfactory soil material and/or unsatisfactory soil material SC,**

CL, and ML as long as the geotechnical engineer deems the material to be suitable and the compaction requirements are met.

3. Under walks and pavements within traffic and parking areas, ie east and below heavy-duty main north/south drive, use satisfactory soil material as long as the geotechnical engineer deems the material to be suitable and the compaction requirements can be met.
4. Synthetic turf athletic fields, use satisfactory soil material and/or unsatisfactory soil material SC, CL, and ML as long as the geotechnical engineer deems the material to be suitable and the compaction requirements are met.
5. Natural athletic fields, use satisfactory soil material and/or unsatisfactory soil material SC, CL, and ML as long as the geotechnical engineer deems the material to be suitable and the compaction requirements are met.
6. Tennis Courts, use engineered fill.
7. Track, use engineered fill.
8. Under steps and ramps, use engineered fill.
9. Under building slabs, use engineered fill.
10. Behind walls, use engineered drainage fill.
11. Under footings and foundations, use engineered fill.
12. Over excavated areas, use engineered fill or lean concrete.

3.13 MOISTURE CONTROL

- A. Uniformly moisten or aerate subgrade and each subsequent fill or backfill layer before compaction to within two (2) percent of optimum moisture content.
 1. Do not place backfill or fill material on surfaces that are muddy, frozen, or contain frost or ice.

3.14 COMPACTION OF BACKFILLS AND FILLS

- A. Place backfill and fill materials in layers not more than 8 inches (200 mm) in loose depth for material compacted by heavy compaction equipment, and not more than 4 inches (100 mm) in loose depth for material compacted by hand-operated tampers.
- B. Place backfill and fill materials evenly on all sides of structures to required elevations, and uniformly along the full length of each structure.
- C. Compact soil to not less than the following percentages of maximum dry unit weight according to ASTM D 698 and ASTM D 1557:
 1. Under structures, building slabs, steps, and pavements, scarify and recompact top 12 inches (300 mm) of existing subgrade and each layer of backfill or fill material at 95 percent.
 2. Under walkways, scarify and recompact top 6 inches (150 mm) below subgrade and compact each layer of backfill or fill material at 95 percent.
 3. Under lawn or unpaved areas, scarify and recompact top 6 inches (150 mm) below subgrade and compact each layer of backfill or fill material at 88 percent.

3.15 GRADING

- A. General: Uniformly grade areas to a smooth surface, free from irregular surface changes. Comply with compaction requirements and grade to cross sections, lines, and elevations indicated.
 - 1. Provide a smooth transition between adjacent existing grades and new grades.
 - 2. Cut out soft spots, fill low spots, and trim high spots to comply with required surface tolerances.
- B. Site Grading: Slope grades to direct water away from buildings and to prevent ponding. Finish Subgrades to required elevations within plus or minus 1 inch.
- C. Grading Inside Grading Lines: Finish subgrade to a tolerance of ½ inch, when tested with a 10 foot straight-edge.
- D. Contractor shall confirm that the proposed grades shown on the plans will not create a ponding water condition (i.e. an unintended low spot or pavement grades of less than 1%).

3.16 SUBSURFACE DRAINAGE

- A. Drainage Piping: Drainage pipe is specified in Division 33 4100 Section for foundation drainage and under-slab drainage systems.
- B. Subsurface Drain: Place a layer of drainage fabric around perimeter of drainage trench. Place a 6 inch course of filter material on drainage fabric to support drainage pipe. Encase drainage in a minimum of 12 inches of filter material and wrap in a drainage fabric, overlapping sides and ends at least 6 inches.
 - 1. Compact each course of filter material to 95 percent of maximum dry unit weight according to ASTM D 698.
- C. Drainage Backfill: Place and compact filter material over subsurface drain, in width indicated, to within 12 inches of final subgrade. Overlay drainage backfill with one layer of drainage fabric, overlapping sides and ends at least 6 inches.
 - 1. Compact each course of filter material to 95 percent of maximum dry density according to ASTM D 698.

3.17 SUBBASE AND BASE COURSES

- A. If indicated on the plans or deemed necessary by the geotechnical engineer, install separation fabric on prepared subgrade according to manufacturer's written instructions, overlapping sides and ends.
- B. Under pavements and walks, place subbase course on separation fabric according to fabric manufacturer's written instructions if fabric is called for on the plan or deemed necessary by the geotechnical engineer.
- C. Under pavements and walks, place base on prepared subbase or subgrade as follows:
 - 1. Place base course material over subbase (or subgrade if subbase is not indicated).
 - 2. Compact subbase and base courses at optimum moisture content to required grades, lines, cross sections, and thickness to not less than 95 percent of maximum dry unit weight according to ASTM D 1557.
 - 3. When thickness of compacted subbase or base course exceeds 6 inches, place materials in equal layers, with no layer more than 6 inches thick or less than 3 inches thick when compacted.

- D. Pavement Shoulders: Place shoulders along edges of subbase and base course to prevent lateral movement. Construct shoulders, at least 12 inches wide, of satisfactory soil materials and compact simultaneously with each subbase and base layers to not less than 95 percent of maximum dry unit weight according to ASTM D 1557.

3.18 DRAINAGE COURSE

- A. Under slabs-on-grade, if indicated on the plans, place drainage fabric on prepared subgrade according to manufacturer's written instructions, overlapping sides and ends.
- B. Under slabs-on-grade, place drainage course on prepared subgrade and as follows:
 - 1. Compact drainage course to required cross sections and thickness to no less than 95 percent of maximum dry unit weight according to ASTM D 698.
 - 2. When compacted thickness of drainage course exceeds 6 inches, place materials in equal layers, with no more than 6 inches thick or less than 3 inches thick when compacted.

3.19 FIELD QUALITY CONTROL

- A. Testing Agency: Construction Manager/Owner will engage a qualified independent Geotechnical engineering testing agency to perform field quality-control testing.
- B. Allow testing agency to inspect and to test any subgrades and each fill or backfill layer. Proceed with subsequent earthwork only after test results for previously completed work. Comply with requirements.
- C. Testing agency will test compaction of soils in place according to ASTM D 1556, ASTM D 2167, ASTM D 2922, and ASTM D 2937, as applicable.
- D. When testing agency reports that subgrades, fills, or backfills have not achieved degree of compaction specified, scarify and moisten or aerate and remove and replace soil to depth required, recompact and retest until specified compaction is obtained.

3.20 PROTECTION

- A. Protecting Graded Areas: Protect newly graded areas from traffic, freezing, and erosion. Keep free of trash and debris.
- B. Repair and reestablish grades to specified tolerances where completed or partially completed surfaces becomes eroded, rutted, settled, or where they lose compaction due to subsequent construction operations or weather conditions.
- C. Except as expressly provided by the Plans and Specifications the Contractor shall protect from damage and preserve all trees and shrubs, on both public and private property, in the vicinity of his operation. Failing this in any instance, the Contractor shall replace any damaged tree or shrub with like kind, size and quality, except as may be otherwise expressly approved by the Landscape Architect. The cost to replace a tree is a minimum of \$500.00 per tree, \$100.00 per shrub, and \$50 per non-woody plant.



3.21 DISPOSAL OF SURPLUS AND WASTE MATERIALS

- A. Disposal: Unless otherwise indicated on the drawings, remove surplus satisfactory soil and waste materials, including unsatisfactory soil, trash, and debris, and legally dispose of it off the Owner's property.
 - 1. Do not burn materials on the Owner's property.

END OF SECTION 31 2000



KALAMAZOO | CHELSEA | GRAND RAPIDS | ROYAL OAK

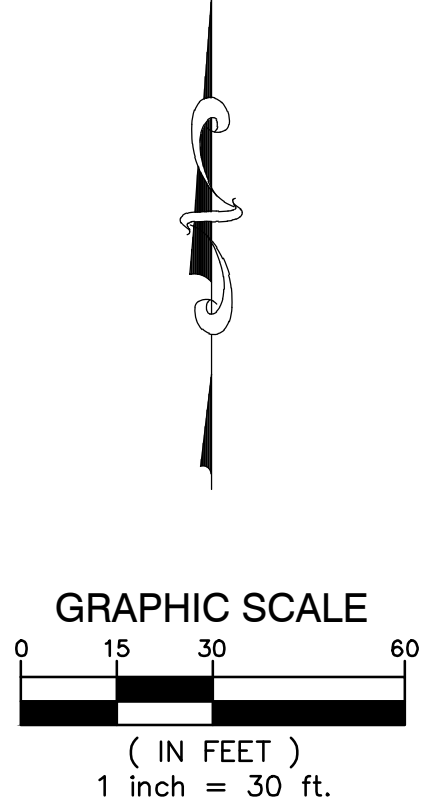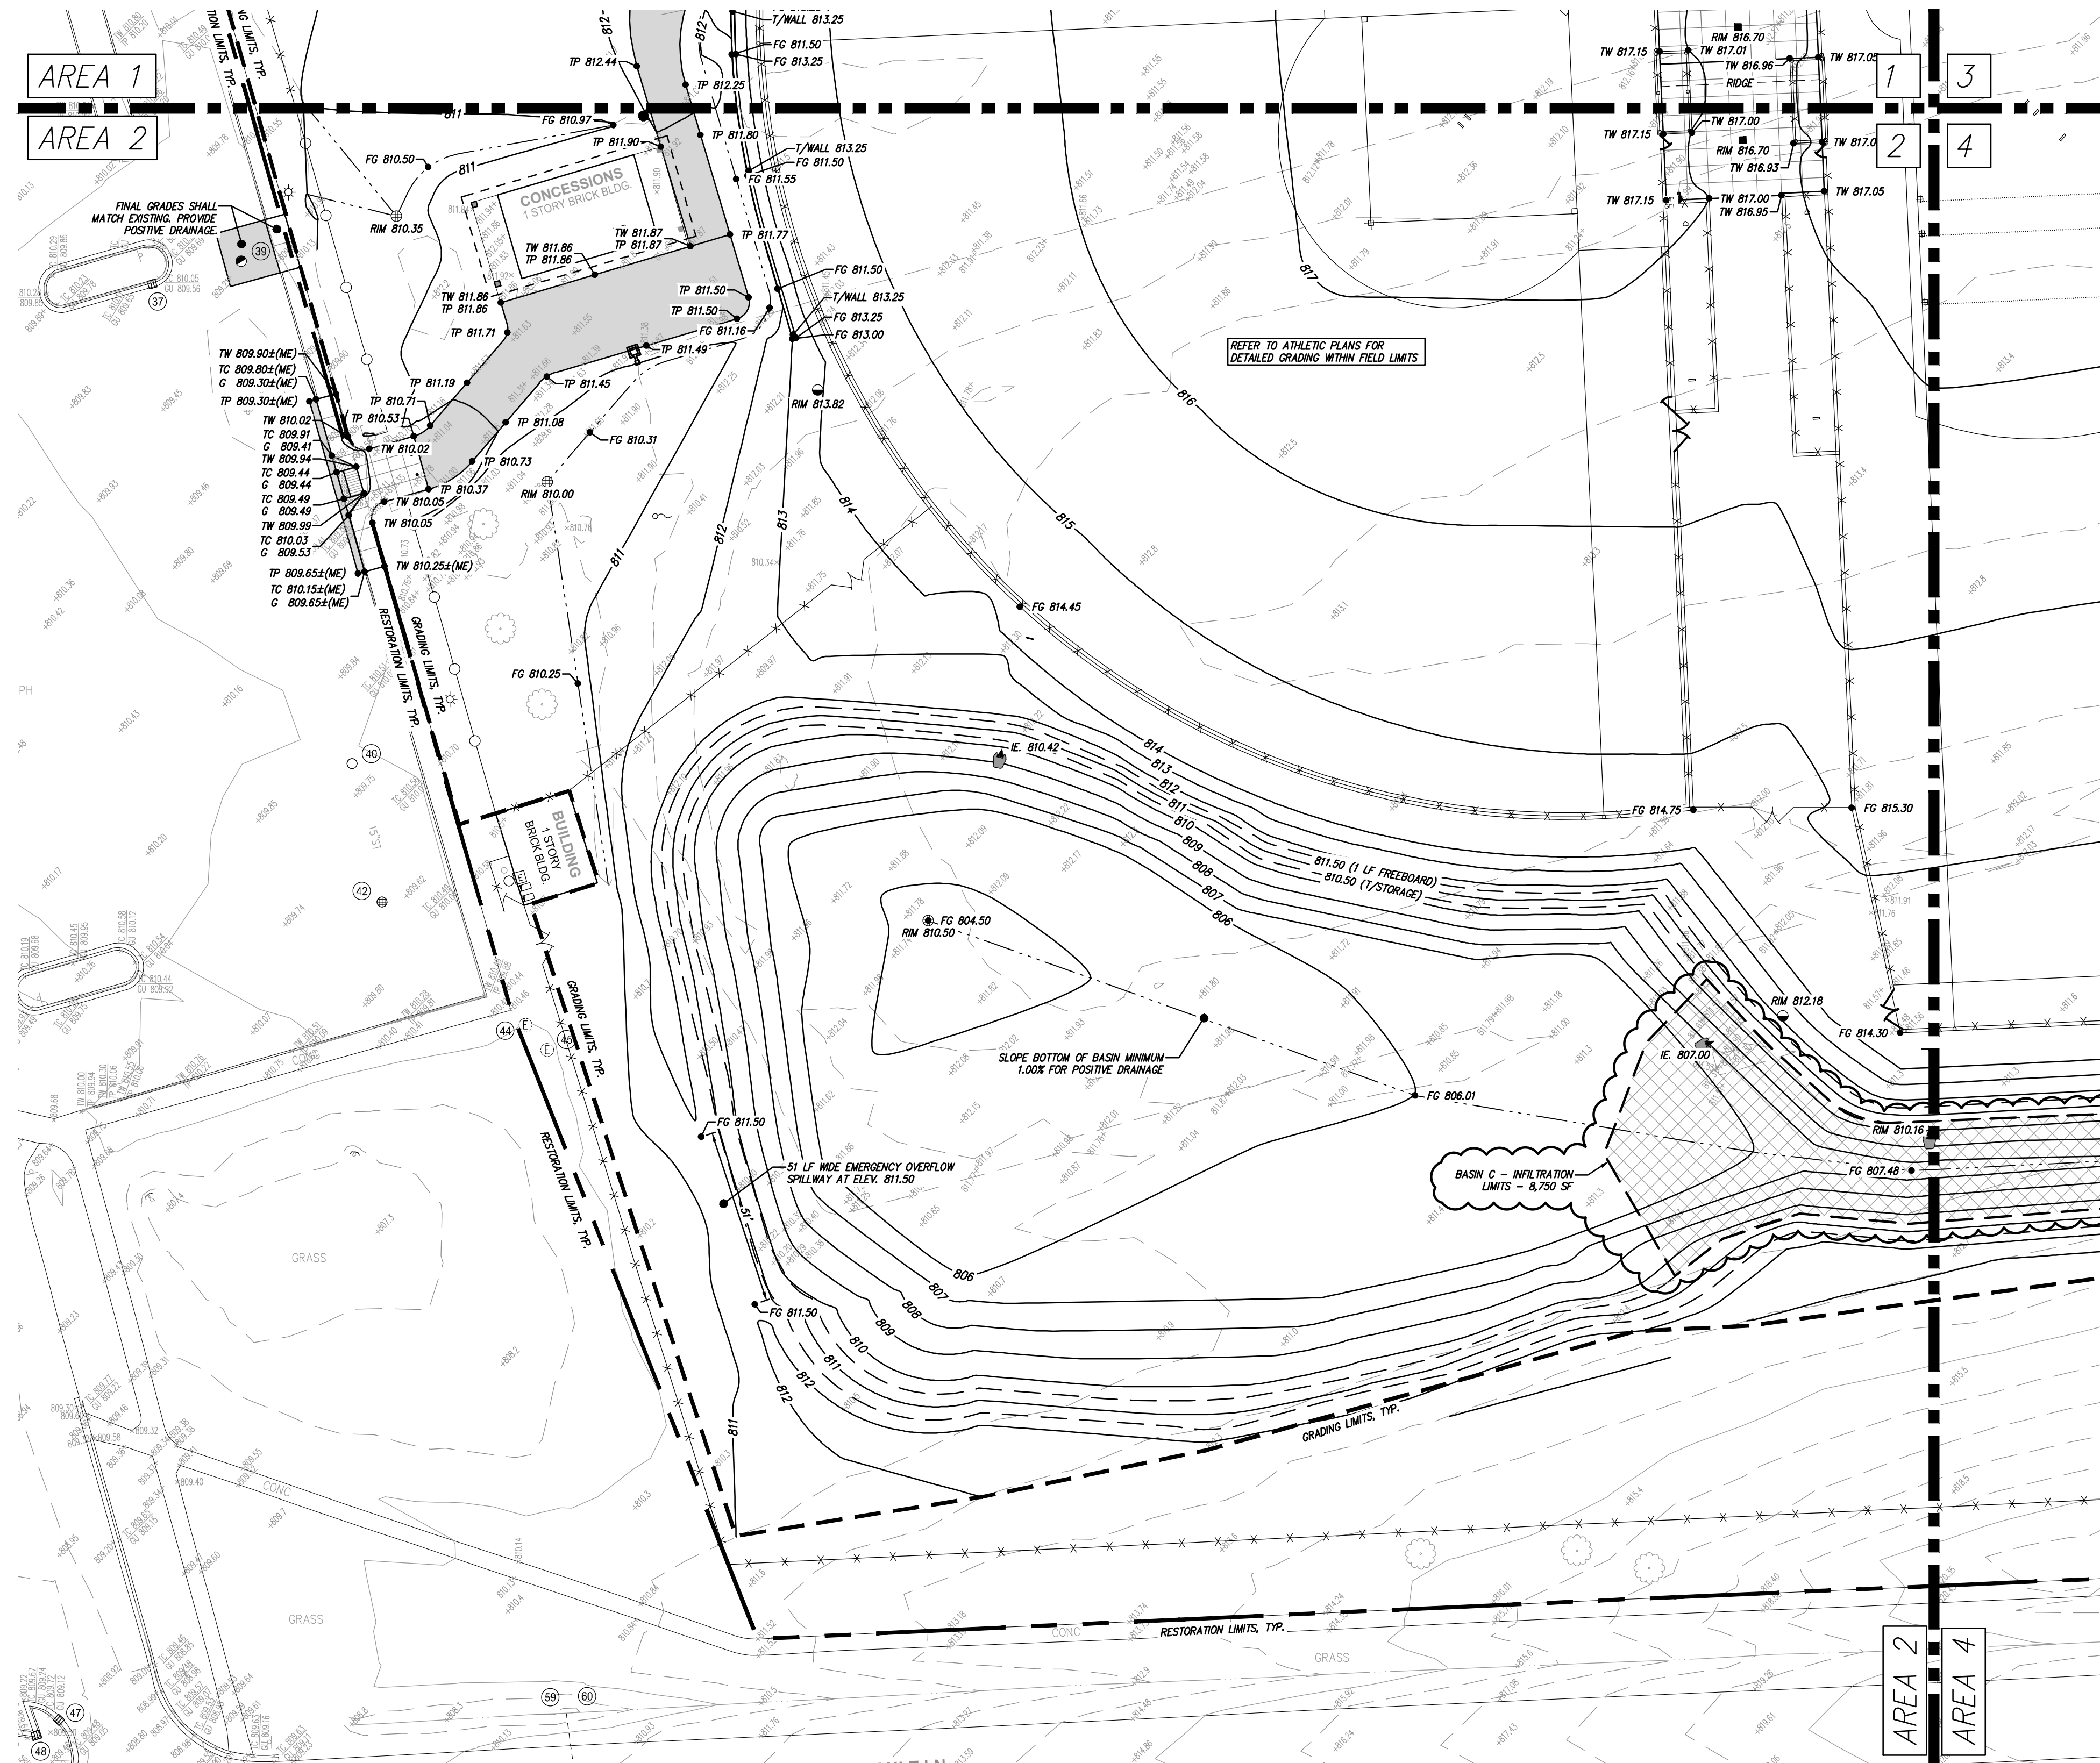

LEGEND

--- PROPOSED WATER MAIN	● PROPOSED SAN MANHOLE (SAM)
--- PROPOSED SANITARY	● PROPOSED STORM MANHOLE (SM)
--- PROPOSED STORM SEWER	■ PROPOSED CATCH BASIN (CB)
--- PROPOSED GAS MAIN	▲ PROPOSED INLET (IN)
--- PROPOSED ELECTRIC	■ PROPOSED END SECTION (ES)
--- PROPOSED HYDRANT	⊕ PROPOSED FIELD CATCH BASIN (FS) W/REINFORCED COVER OR STANDPIPE (SP) W/ BAR GRATE COVER
○ PROPOSED GATE VALVE & WELL (GVW)	⊕ PROPOSED FIELD CATCH BASIN (FS) W/REINFORCED COVER OR STANDPIPE (SP) W/ BAR GRATE COVER
○ PROPOSED TAPPING SLAVE VALVE & WELL (TSVW)	⊕ UTILITY CROSSING (SEE DATA TABLE)
■ STANDARD BITUMINOUS PAVEMENT	CB STRUCT. TYPE
■ HEAVY-DUTY BITUMINOUS PAVEMENT	Z STRUCT. NO.
■ DEEP STRENGTH BITUMINOUS PAVEMENT	20
■ BITUMINOUS PAVEMENT OVERLAY	10 STRUCT. NO.
■ CONCRETE PAVEMENT	XXX STRUCT. TYPE
■ CONCRETE SIDEWALK	
■ MILL PAVEMENT	

GRADING LEGEND

--- EXISTING ELEVATION	● TP 000.00 TOP OF PAVEMENT ELEVATION
--- PROPOSED TOP OF CURB ELEVATION	● TW 000.00 TOP OF WALK ELEVATION
--- PROPOSED GUTTER ELEVATION	● FG 000.00 FINISH GRADE ELEVATION
--- PROPOSED OUTSIDE GRADE ELEVATION	● T/WALL 000.00 TOP OF WALL ELEVATION
--- EXISTING CONTOURS	● ME 000.00 MATCH EXISTING ELEVATION
--- PROPOSED CONTOURS	--- FLOW ARROW

- GRADING NOTES**
- CONTRACTOR TO PLACE ALL NEW PAVEMENT TO THE GRADES INDICATED OR MATCH ORIGINAL GRADES IF NEW GRADES ARE NOT SHOWN. CONTRACTOR SHALL CONFIRM MINIMUM 1% PAVEMENT SLOPES ARE ATTAINED IN ALL AREAS.
 - PROPOSED GRADES MAY BE BASED ON AN INTERPOLATION OF DATA SHOWN ON THE TOPOGRAPHIC SURVEY. THIS INTERPOLATED DATA IS APPROXIMATE AND COULD DIFFER SLIGHTLY BASED ON THE ACCURACY OF THE SURVEY. CONTRACTOR SHALL CONFIRM THAT THE PROPOSED GRADES SHOWN ON THIS PLAN WILL NOT CREATE A STANDING WATER CONDITION (I.E. A LOW SPOT OR PAVEMENT SLOPES LESS THAN 1% OR AN UNSAFE CONDITION WITH SLOPES IN EXCESS OF 12%. CONTRACTOR SHALL NOTIFY ENGINEER IMMEDIATELY IF THEY BELIEVE THAT ONE OF THESE SITUATIONS WILL OCCUR BASED ON THE PROPOSED GRADES.
 - ALL PAVEMENT PLACED WITHIN BARRIER FREE PARKING AREAS (STALLS AND ACCESS AISLES) SHALL HAVE A MAXIMUM SLOPE OF 2% IN ANY DIRECTION, INCLUDING REASSED DIAGONALLY ACROSS THE AREAS. CONTRACTOR SHALL ADJUST SLOPES AS NECESSARY TO PROVIDE ADA COMPLIANT SLOPES AS WELL AS PROVIDING RE-GRADED TRANSITION SLOPES OUTSIDE OF THE BARRIER FREE PARKING AREAS. CONTRACTOR SHALL NOTIFY ENGINEER IMMEDIATELY IF TRANSITION ZONES WILL EXCEED MAXIMUM 4% SLOPES. CONTRACTOR SHALL MAINTAIN POSITIVE DRAINAGE PATTERNS WITH ALL NECESSARY PAVEMENT RE-GRADES.
 - ALL BARRIER FREE RAMPS AND ADA ACCESSIBLE ROUTES SHALL BE CONSTRUCTED IN ACCORDANCE WITH THE CURRENT VERSION OF MDT DETAIL R-28 "SIDEWALK RAMP AND DETECTABLE WARNING DETAILS".
 - CONTRACTOR IS RESPONSIBLE FOR CONTROLLING STORM WATER RUNOFF DURING CONSTRUCTION OPERATIONS. IF PARTICULAR CONCERN WILL BE THE PERIOD AFTER THE SITE HAS BEEN STRIPPED AND NOT YET RESTORED, BUILT UPON, OR PAVED, CONTRACTOR MUST INSTALL OR CONSTRUCT APPROPRIATE TEMPORARY MEASURES TO PROTECT ADJACENT PROPERTIES.

RESTORATION NOTE

RESTORE ALL NON-PAVED AREAS WITH 1" OF CLEAN TOPSOIL AND SEED MIX (50% KENTUCKY BLUEGRASS, 30% PERENNIAL PRAIRIEGRASS, 20% CREEPING RED FESCUE). PLACE MULCH IN ALL SEEDING AREAS ON SLOPES IN EXCESS OF 1% HORIZONTAL TO 1 VERTICAL. PLACE NORTH AMERICAN GREEN OSIRO MULCH (BLANKET IMMEDIATELY AFTER SEEDING. USE METAL STAPLES PER MANUFACTURERS RECOMMENDATIONS TO HOLD MATING IN PLACE.

MS REC COMPLEX

SALINE AREA SCHOOLS

7190 N. Maple Rd. Saline, MI 48176



REVISIONS/REVIEW



REVISIONS/REVIEW	DATE
SCHEMATIC DESIGN	05/02/2024
DESIGN DEVELOPMENT	08/22/2024
CONSTRUCTION DOCUMENTS	10/24/2024
ADDENDUM #1	11/20/2024
ADDENDUM #2	11/26/2024
WCWRC SUBMITTAL #1	12/06/2024
ADDENDUM #4	12/10/2024

JOB NO. **2900-09A**
 SHEET TITLE
 Grading Plan - (Area 2)

SHEET NO.
C6.2



KALAMAZOO | CHELSEA | GRAND RAPIDS | ROYAL OAK

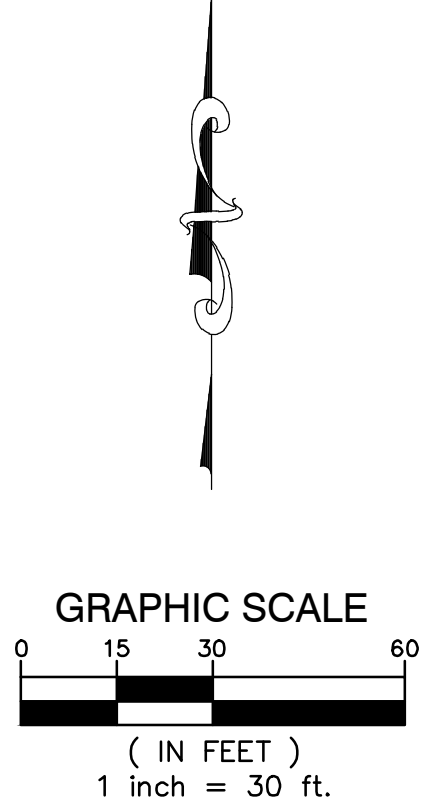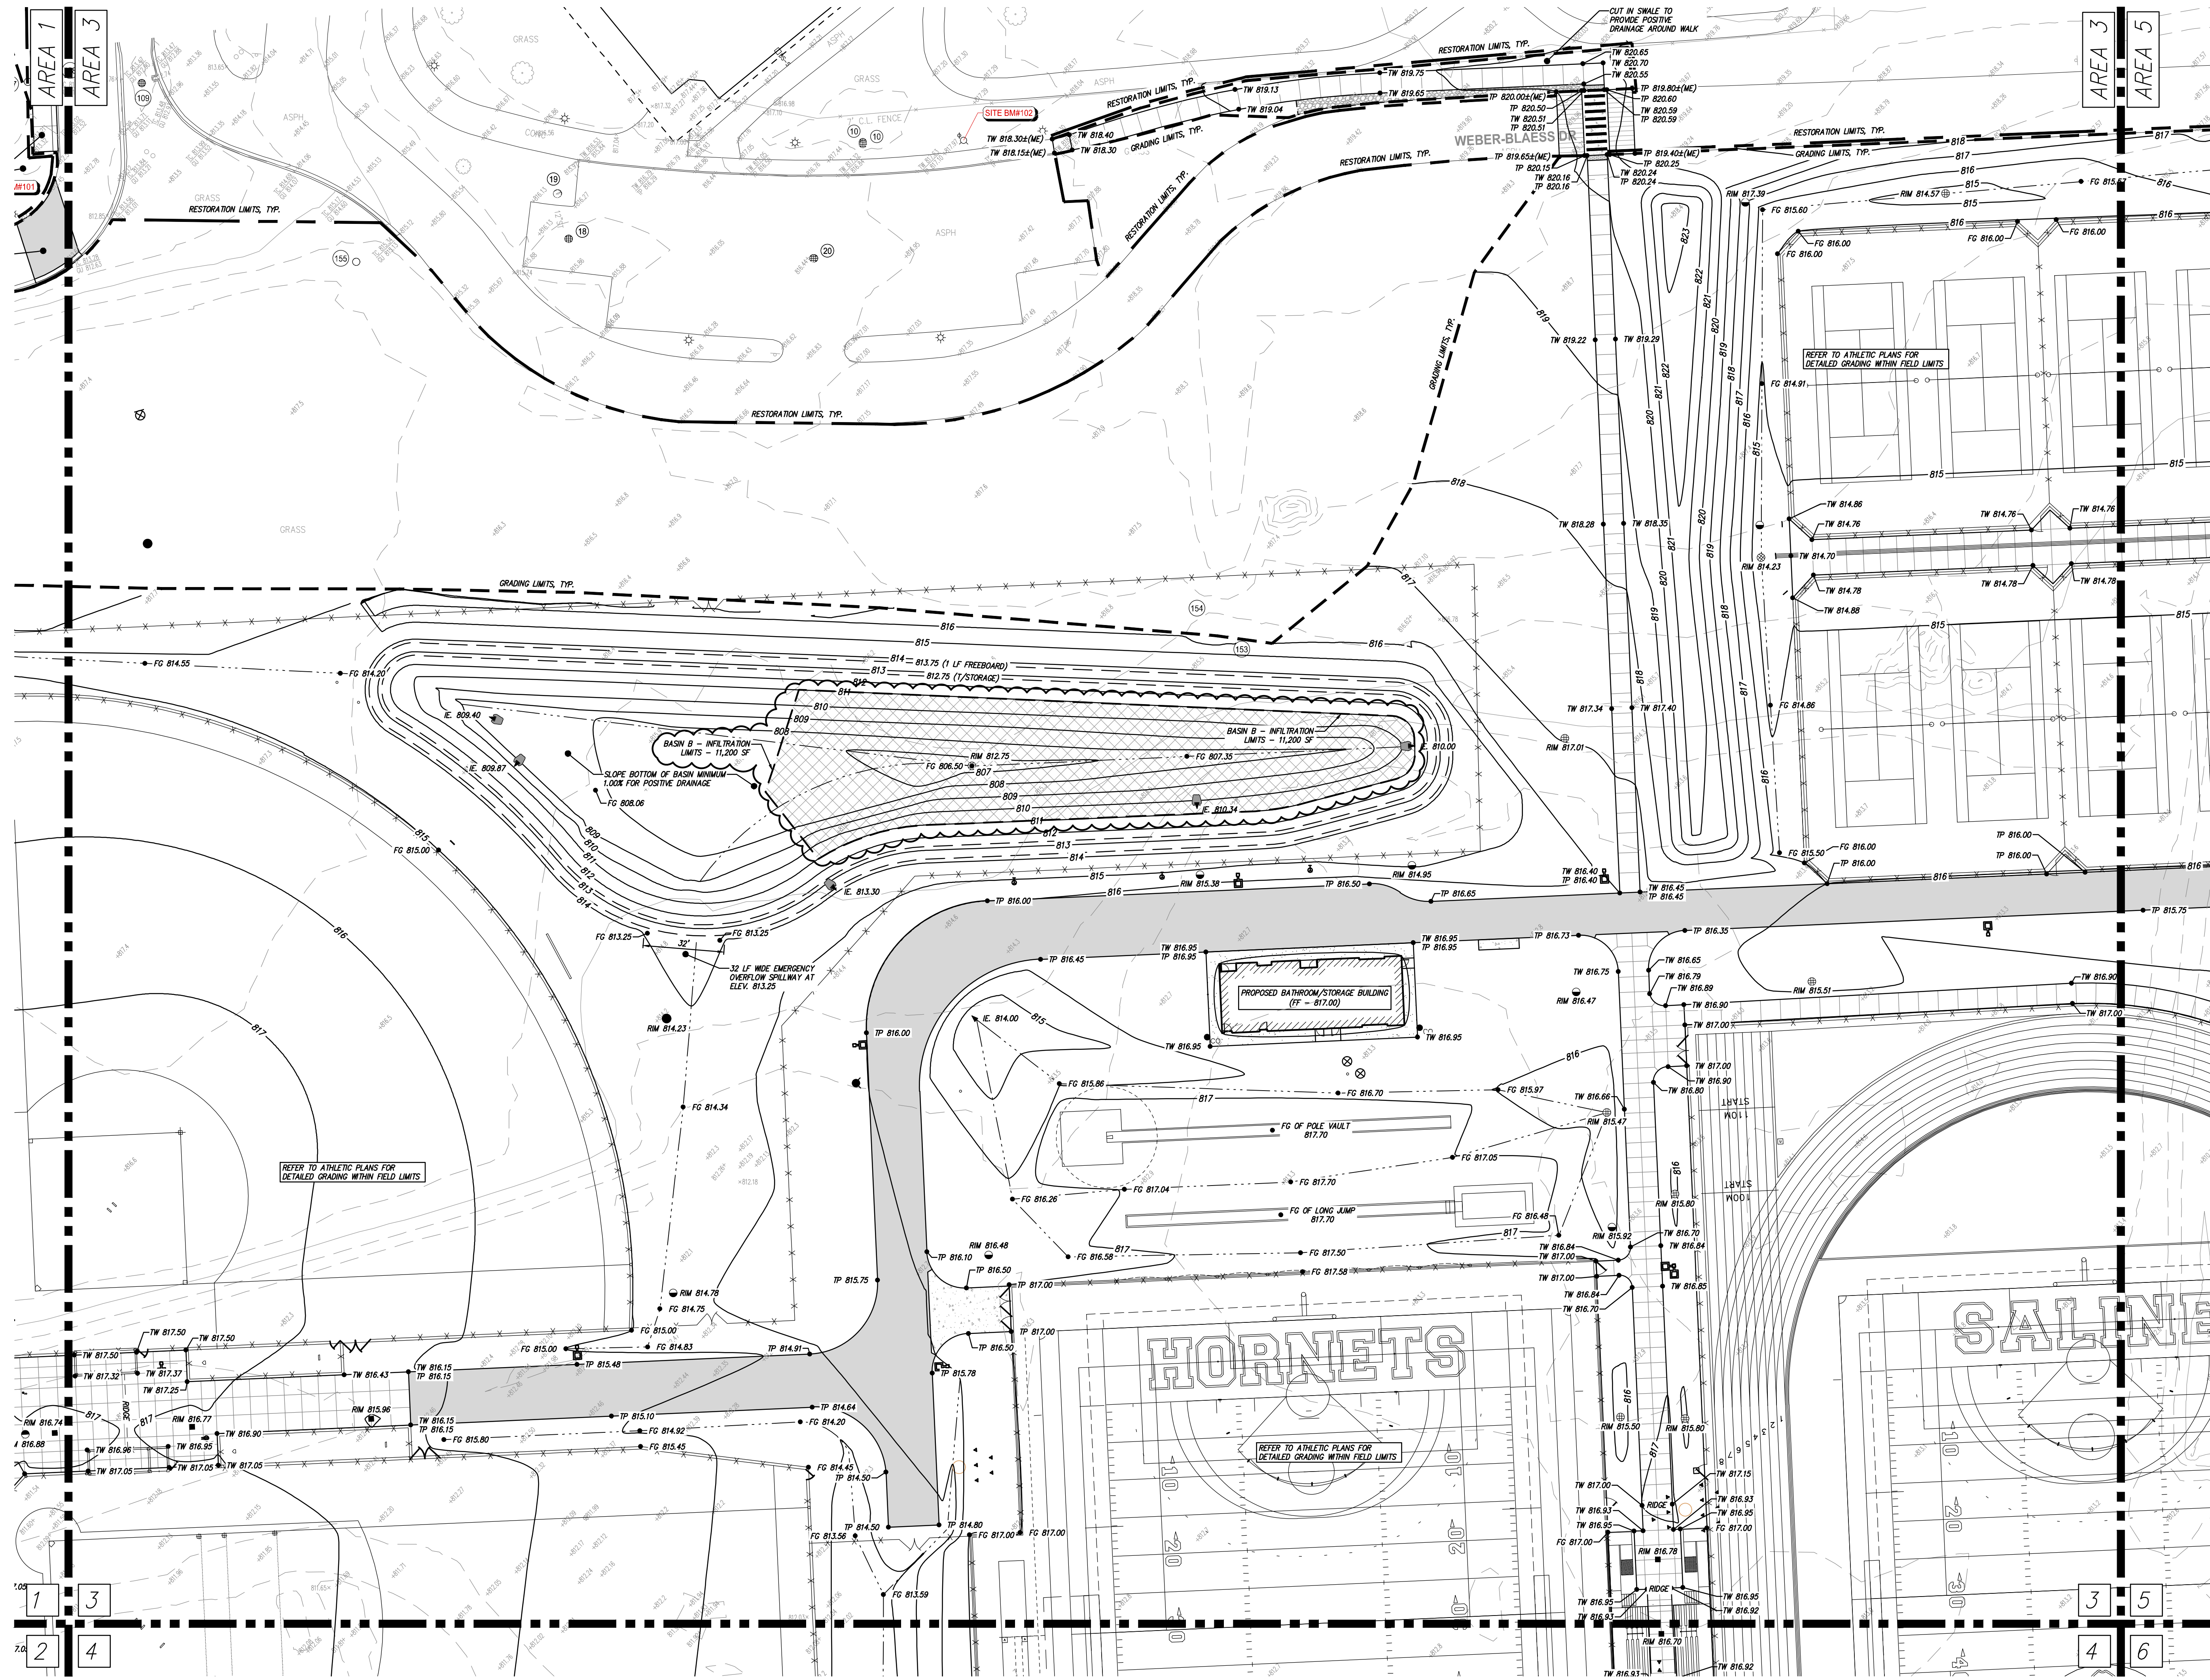

LEGEND

--- PROPOSED WATERMAIN	● PROPOSED SAN MANHOLE (SAM)
--- PROPOSED SANITARY	● PROPOSED STORM MANHOLE (SM)
--- PROPOSED STORM SEWER	■ PROPOSED CATCH BASIN (CB)
--- PROPOSED GAS MAIN	▲ PROPOSED INLET (IN)
--- PROPOSED ELECTRIC	■ PROPOSED END SECTION (ES)
--- PROPOSED HYDRANT	⊕ PROPOSED FIELD CATCH BASIN (FCB) W/REINFORCED COVER OR STANDPIPE (SP) W/ BAR GRATE COVER
○ PROPOSED GATE VALVE & WELL (GVW)	⊕ PROPOSED FIELD CATCH BASIN (FCB) W/REINFORCED COVER OR STANDPIPE (SP) W/ BAR GRATE COVER
○ PROPOSED TAPPING SLLEEVE VALVE & WELL (TSV)	⊕ PROPOSED FIELD CATCH BASIN (FCB) W/REINFORCED COVER OR STANDPIPE (SP) W/ BAR GRATE COVER
--- STANDARD BITUMINOUS PAVEMENT	⊕ UTILITY CROSSING (SEE DATA TABLE)
--- HEAVY-DUTY BITUMINOUS PAVEMENT	⊕ STRUCT. TYPE
--- DEEP STRENGTH BITUMINOUS PAVEMENT	⊕ STRUCT. NO.
--- BITUMINOUS PAVEMENT OVERLAY	⊕
--- CONCRETE PAVEMENT	⊕ STRUCT. NO.
--- CONCRETE SIDEWALK	⊕ STRUCT. TYPE
--- MILL PAVEMENT	

GRADING LEGEND

--- EXISTING ELEVATION	● TP 000.00 TOP OF PAVEMENT ELEVATION
--- TP 000.00 PROPOSED TOP OF CURB ELEVATION	● TW 000.00 TOP OF WALK ELEVATION
--- FG 000.00 PROPOSED OUTER ELEVATION	● FG 000.00 FINISH GRADE ELEVATION
--- OG 000.00 OUTSIDE GRADE ELEVATION	● 1/2 WALL 000.00 TOP OF WALL ELEVATION
--- EXISTING CONTOURS	● ME 000.00 MATCH EXISTING ELEVATION
--- 1130 PROPOSED CONTOURS	--- FLOW ARROW

- GRADING NOTES**
- CONTRACTOR TO PLACE ALL NEW PAVEMENT TO THE GRADES INDICATED OR MATCH ORIGINAL GRADES IF NEW GRADES ARE NOT SHOWN. CONTRACTOR SHALL CONFIRM MINIMUM 1% PAVEMENT SLOPES ARE ATTAINED IN ALL AREAS.
 - PROPOSED GRADES MAY BE BASED ON AN INTERPOLATION OF DATA SHOWN ON THE TOPOGRAPHIC SURVEY. THIS INTERPOLATED DATA IS APPROXIMATE AND COULD DIFFER SLIGHTLY BASED ON THE ACCURACY OF THE SURVEY. CONTRACTOR SHALL CONFIRM THAT THE PROPOSED GRADES SHOWN ON THIS PLAN WILL NOT CREATE A STANDING WATER CONDITION (I.E. A LOW SPOT OF PAVEMENT SLOPES LESS THAN 1% OR AN UNSAFE CONDITION WITH SLOPES IN EXCESS OF 3%. CONTRACTOR SHALL NOTIFY ENGINEER IMMEDIATELY IF THEY BELIEVE THAT ONE OF THESE SITUATIONS WILL OCCUR BASED ON THE PROPOSED GRADES.
 - ALL PAVEMENT PLACED WITHIN BARRIER FREE PARKING AREAS (STALLS AND ACCESS AISLES) SHALL HAVE A MAXIMUM SLOPE OF 2% IN ANY DIRECTION, INCLUDING HEADWAYS DIAGONALLY ACROSS THE AREAS. CONTRACTOR SHALL ADJUST SLOPES AS NECESSARY TO PROVIDE ADA COMPLIANT SLOPES AS WELL AS PROVIDING RE-GRADED TRANSITION SLOPES OUTSIDE OF THE BARRIER FREE PARKING AREAS. CONTRACTOR SHALL NOTIFY ENGINEER IMMEDIATELY IF TRANSITION SLOPES WILL EXCEED MAXIMUM 4% SLOPES. CONTRACTOR SHALL MAINTAIN POSITIVE DRAINAGE PATTERNS WITH ALL NECESSARY PAVEMENT RE-GRADES.
 - ALL BARRIER FREE RAMPS AND ADA ACCESSIBLE ROUTES SHALL BE CONSTRUCTED IN ACCORDANCE WITH THE CURRENT VERSION OF MDT DETAIL R-28 "SIDEWALK RAMP AND DETECTABLE WARNING DETAILS".
 - CONTRACTOR IS RESPONSIBLE FOR CONTROLLING STORM WATER RUNOFF DURING CONSTRUCTION OPERATIONS. IF PARTICULAR CONCERN WILL BE THE PERIOD AFTER THE SITE HAS BEEN STRIPPED AND NOT YET RESTORED, BUILT UPON, OR PAVED, CONTRACTOR MUST INSTALL OR CONSTRUCT APPROPRIATE TEMPORARY MEASURES TO PROTECT ADJACENT PROPERTIES.

RESTORATION NOTE

RESTORE ALL NON-PAVED AREAS WITH 1" OF CLEAN TOPSOIL AND SEED MIX (50% KENTUCKY BLUEGRASS, 30% PERENNIAL PEGGYRASS, 20% CREEPING RED FESCUE). PLACE MULCH IN ALL SEDED AREAS ON SLOPES IN EXCESS OF 1% HORIZONTAL TO 1 VERTICAL PLACE NORTH AMERICAN GREEN OSIRO MULCH (BLANK) IMMEDIATELY AFTER SEEDING. USE METAL STAPLES PER MANUFACTURERS RECOMMENDATIONS TO HOLD MATING IN PLACE.

MS REC COMPLEX

SALINE AREA SCHOOLS

7190 N. Maple Rd. Saline, MI 48176



REVISIONS/REVIEW



REVISIONS/REVIEW	DATE
SCHEMATIC DESIGN	05/02/2024
DESIGN DEVELOPMENT	08/22/2024
CONSTRUCTION DOCUMENTS	10/24/2024
ADDENDUM #1	11/20/2024
ADDENDUM #2	11/26/2024
WCWRC SUBMITTAL #1	12/06/2024
ADDENDUM #4	12/10/2024

JOB NO. **2900-09A**
SHEET TITLE
Grading Plan - (Area 3)

SHEET NO.
C6.3



KALAMAZOO | CHELSEA | GRAND RAPIDS | ROYAL OAK

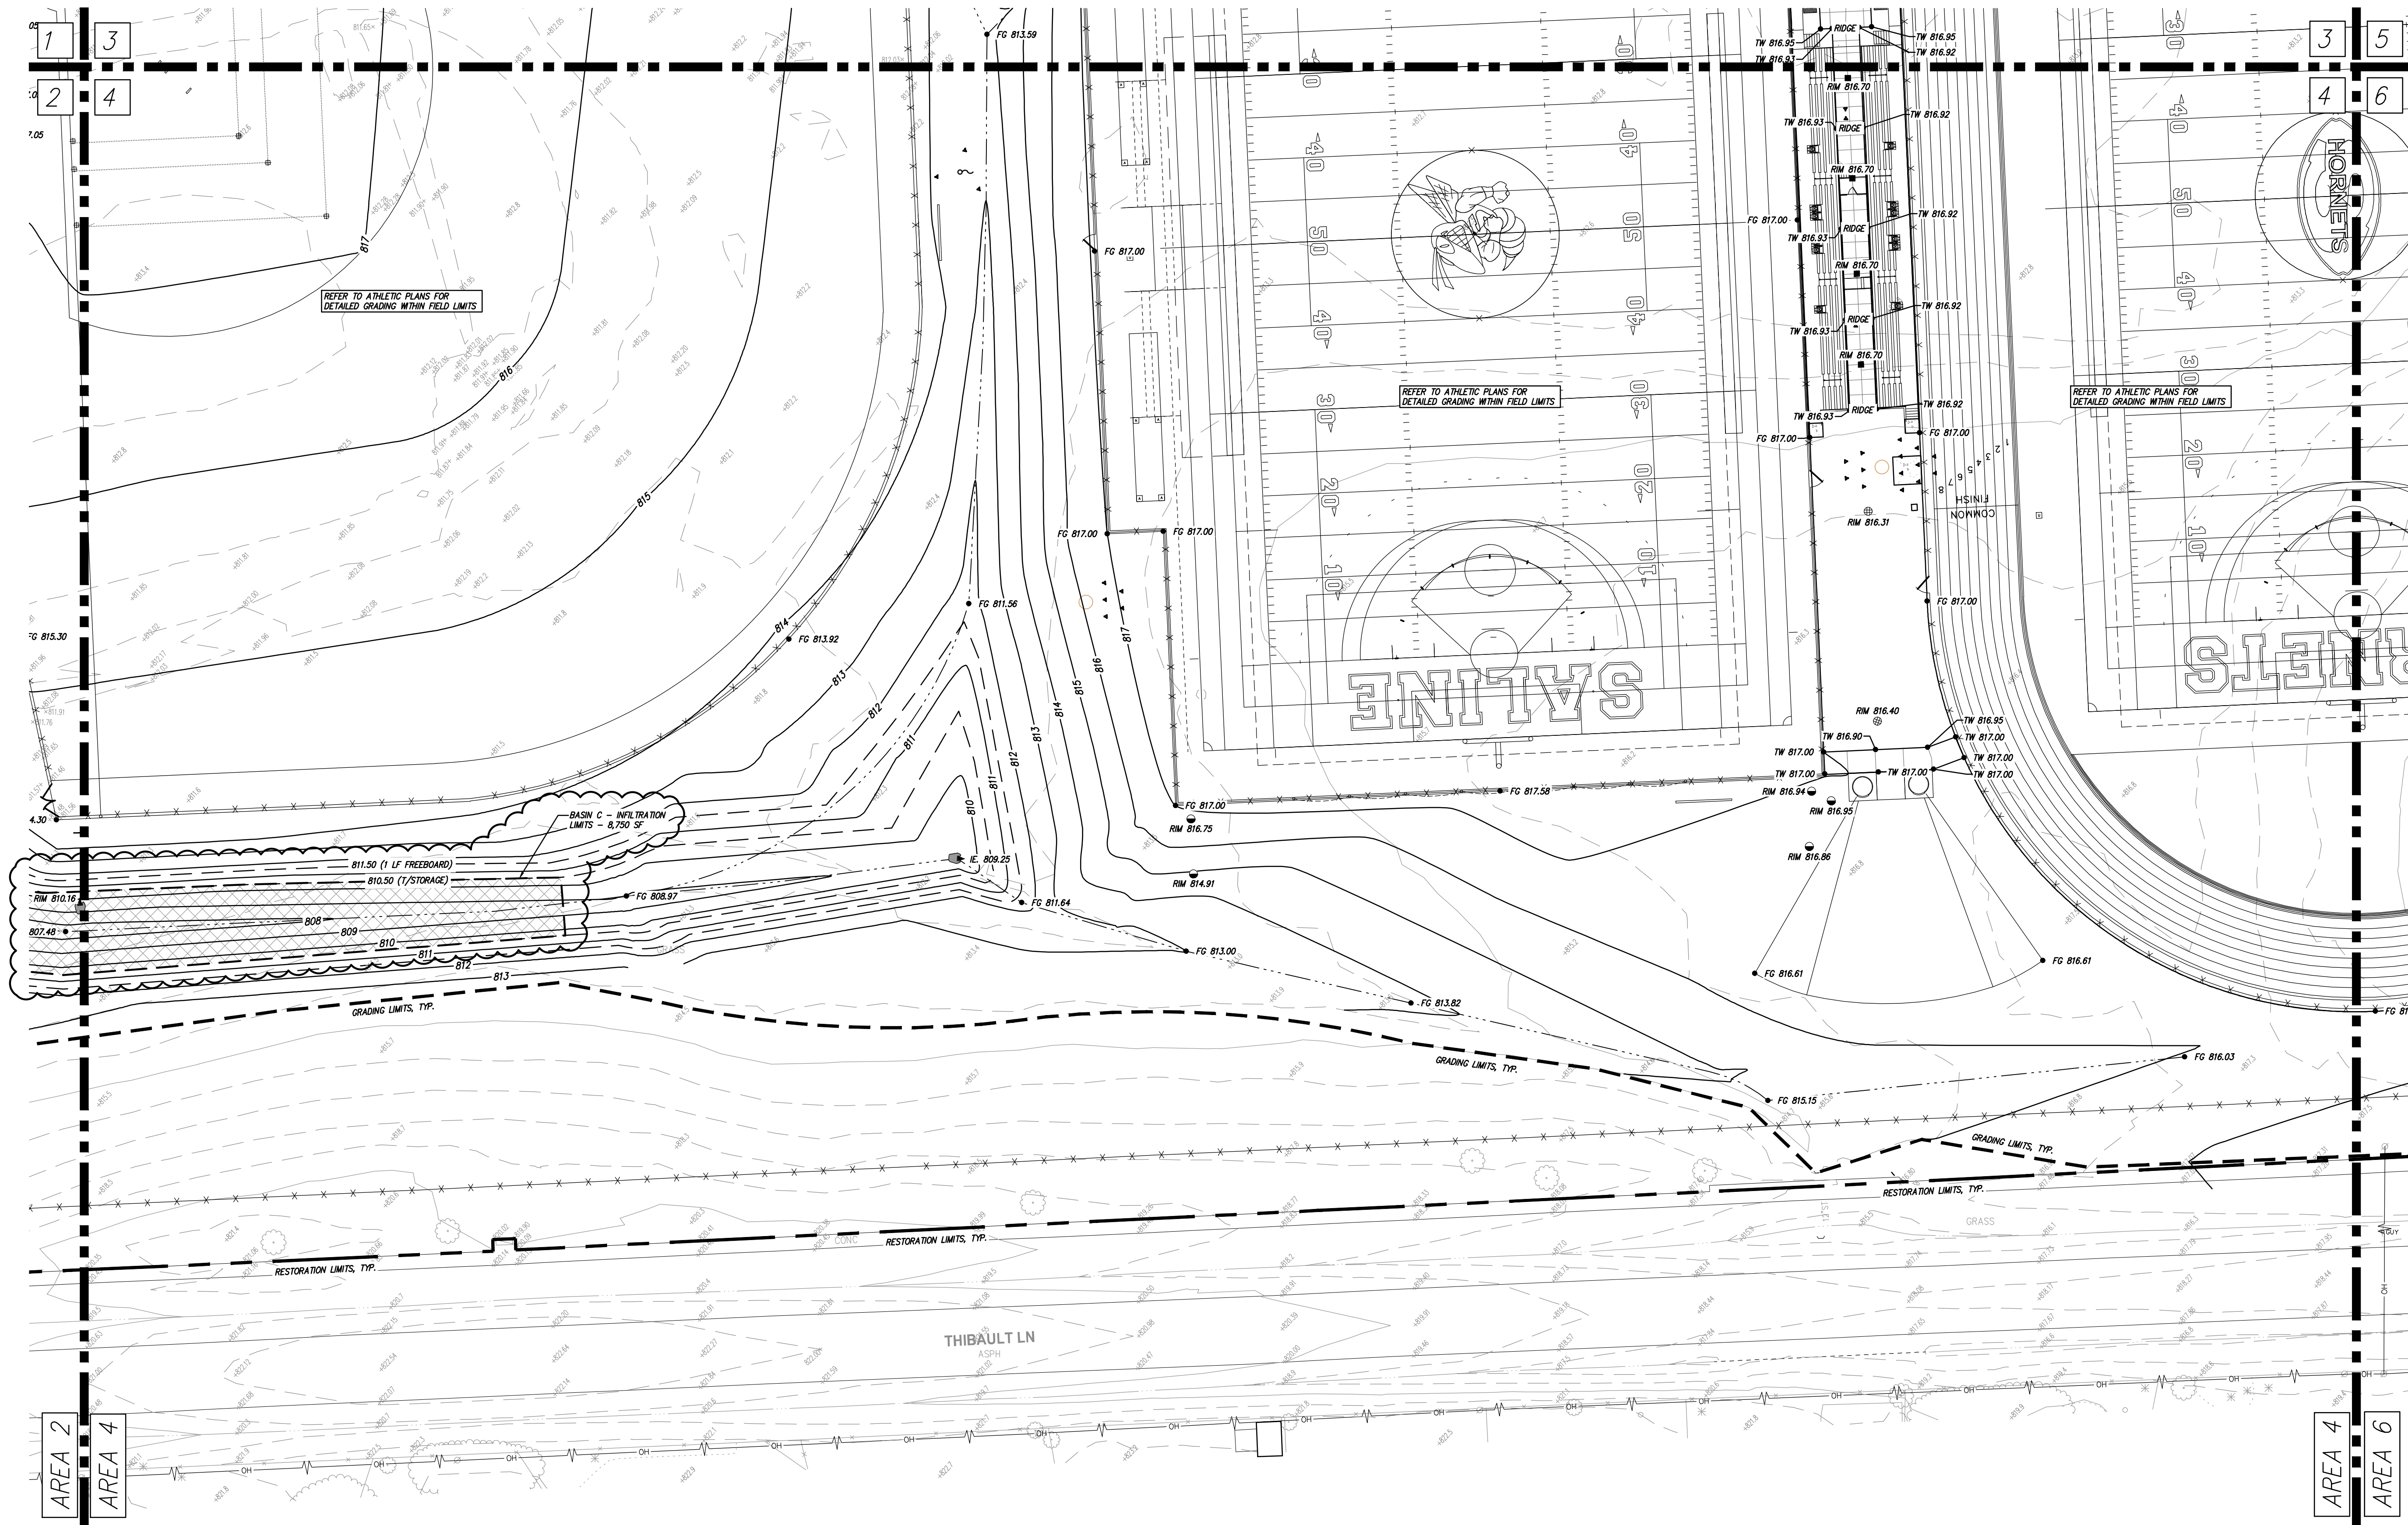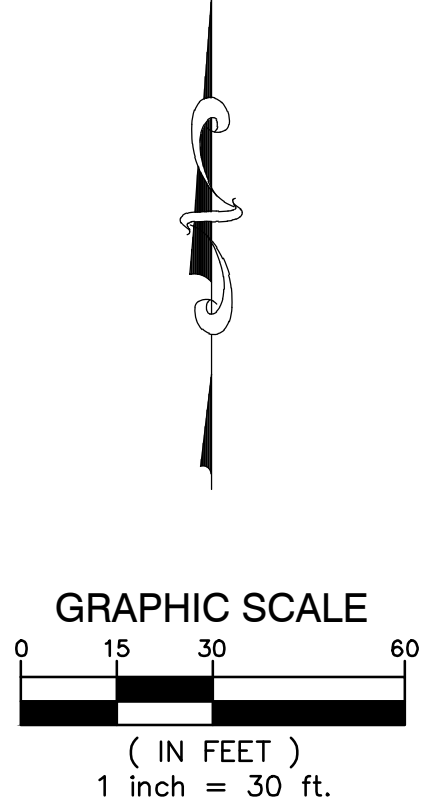

LEGEND

--- PROPOSED WATERMAIN	● PROPOSED SAN MANHOLE (SAM)
--- PROPOSED SANITARY	● PROPOSED STORM MANHOLE (SM)
--- PROPOSED STORM SEWER	■ PROPOSED CATCH BASIN (CB)
--- PROPOSED GAS MAIN	▲ PROPOSED INLET (AI)
--- PROPOSED ELECTRIC	▲ PROPOSED END SECTION (ES)
● PROPOSED HYDRANT	⊕ PROPOSED END SECTION (ES)
○ PROPOSED GATE VALVE & WELL (GVW)	⊕ PROPOSED FIELD CATCH BASIN (FCB) W/ BREEZE COVER OR STANDPIPE (SP) W/ BAR GRATE COVER
○ PROPOSED TAPPING SLEEVE VALVE & WELL (TSVW)	⊕ UTILITY CROSSING (SEE DATA TABLE)
■ STANDARD BITUMINOUS PAVEMENT	⊕ STORM SEWER STRUCTURE
■ HEAVY-DUTY BITUMINOUS PAVEMENT	⊕ STORM SEWER STRUCTURE
■ DEEP STRENGTH BITUMINOUS PAVEMENT	⊕ SANITARY SEWER STRUCTURE
■ BITUMINOUS PAVEMENT OVERLAY	⊕ WATERMAIN STRUCTURE
■ CONCRETE PAVEMENT	⊕ WATERMAIN STRUCTURE
■ CONCRETE SIDEWALK	⊕ MLL PAVEMENT

GRADING LEGEND

--- EXISTING ELEVATION	● TP 000.00 TOP OF PAVEMENT ELEVATION
--- PROPOSED TOP OF CURB ELEVATION	● TW 000.00 TOP OF WALK ELEVATION
--- PROPOSED TOP OF GUTTER ELEVATION	● FG 000.00 FINISH GRADE ELEVATION
--- PROPOSED OUTSIDE GRADE ELEVATION	● ME 000.00 MATCH EXISTING ELEVATION
--- EXISTING CONTOURS	--- FLOW ARROW
--- PROPOSED CONTOURS	

- GRADING NOTES**
- CONTRACTOR TO PLACE ALL NEW PAVEMENT TO THE GRADES INDICATED OR MATCH ORIGINAL GRADES IF NEW GRADES ARE NOT SHOWN. CONTRACTOR SHALL CONFIRM MINIMUM 1% PAVEMENT SLOPES ARE ATTAINED IN ALL AREAS.
 - PROPOSED GRADES MAY BE BASED ON AN INTERPOLATION OF DATA SHOWN ON THE TOPOGRAPHIC SURVEY. THIS INTERPOLATED DATA IS APPROXIMATE AND COULD DIFFER SLIGHTLY BASED ON THE ACCURACY OF THE SURVEY. CONTRACTOR SHALL CONFIRM THAT THE PROPOSED GRADES SHOWN ON THIS PLAN WILL NOT CREATE A STANDING WATER CONDITION (I.E. A LOW SPOT OR PAVEMENT SLOPES LESS THAN 1% OR AN UNSAFE CONDITION WITH SLOPES IN EXCESS OF 3%. CONTRACTOR SHALL NOTIFY ENGINEER IMMEDIATELY IF THEY BELIEVE THAT ONE OF THESE SITUATIONS WILL OCCUR BASED ON THE PROPOSED GRADES.
 - ALL PAVEMENT PLACED WITHIN BARRIER FREE PARKING AREAS (STALLS AND ACCESS AISLES) SHALL HAVE A MAXIMUM SLOPE OF 2% IN ANY DIRECTION, INCLUDING REARWARDS DIAGONALLY ACROSS THE AREAS. CONTRACTOR SHALL ADJUST SLOPES AS NECESSARY TO PROVIDE ADA COMPLIANT SLOPES AS WELL AS PROVIDING RE-GRADED DRAINAGE SLOPES OUTSIDE OF THE BARRIER FREE PARKING AREAS. CONTRACTOR SHALL NOTIFY ENGINEER IMMEDIATELY IF TRANSITION ZONES WILL EXCEED MAXIMUM 4% SLOPES. CONTRACTOR SHALL MAINTAIN POSITIVE DRAINAGE PATTERNS WITH ALL NECESSARY PAVEMENT RE-GRADING.
 - ALL BARRIER FREE RAMPS AND ADA ACCESSIBLE ROUTES SHALL BE CONSTRUCTED IN ACCORDANCE WITH THE CURRENT VERSION OF MDT DETAIL R-28 "SIDEWALK RAMP AND DETECTABLE WARNING DETAILS".
 - CONTRACTOR IS RESPONSIBLE FOR CONTROLLING STORM WATER RUNOFF DURING CONSTRUCTION OPERATIONS. IF PARTICULAR CONCERN WILL BE THE TIME PERIOD AFTER THE SITE HAS BEEN STORMED AND NOT YET RESTORED, BUILT UPON, OR PAVED, CONTRACTOR MUST INSTALL OR CONSTRUCT APPROPRIATE TEMPORARY MEASURES TO PROTECT ADJACENT PROPERTIES.

RESTORATION NOTE

RESTORE ALL NON-PAVED AREAS WITH 1" OF CLEAN TOPSOIL AND SEED MIX (50% KENTUCKY BLUEGRASS, 30% PERENNIAL PEGGYRASS, 20% CREEPING RED FESCUE). PLACE MULCH IN ALL SEEDED AREAS ON SLOPES IN EXCESS OF 10 HORIZONTAL TO 1 VERTICAL PLACE NORTH AMERICAN GREEN D370 MULCH BLANKET IMMEDIATELY AFTER SEEDING. USE METAL STAPLES PER MANUFACTURERS RECOMMENDATIONS TO HOLD MATING IN PLACE.

MS REC COMPLEX

SALINE AREA SCHOOLS

7190 N. Maple Rd. Saline, MI 48176



REVISIONS/REVIEW	DATE
SCHEMATIC DESIGN	05/02/2024
DESIGN DEVELOPMENT	08/22/2024
CONSTRUCTION DOCUMENTS	10/24/2024
ADDENDUM #1	11/20/2024
ADDENDUM #2	11/26/2024
WCWRC SUBMITTAL #1	12/06/2024
ADDENDUM #4	12/10/2024

JOB NO. **2900-09A**
 SHEET TITLE
 Grading Plan - (Area 4)

SHEET NO.
C6.4